


WORCESTER DISTRICT REGISTRY
OF DEEDS - WORCESTER, MA
PLAN BOOK 607 PLAN 52
RECORDED SEP 29 1988
9 22 AM
ATTEST: *[Signature]*
Register

I CERTIFY THAT THIS PLAN HAS BEEN
PREPARED IN CONFORMITY WITH THE
RULES AND REGULATIONS OF THE
REGISTERS OF DEEDS OF THE
COMMONWEALTH OF MASSACHUSETTS.

Paul J. Desimone
DATE: 11/7/87

RECORDED
WORCESTER DISTRICT
SEP 29 1988
9 22 AM
Antony
REGISTER


FOR REGISTRY USE ONLY

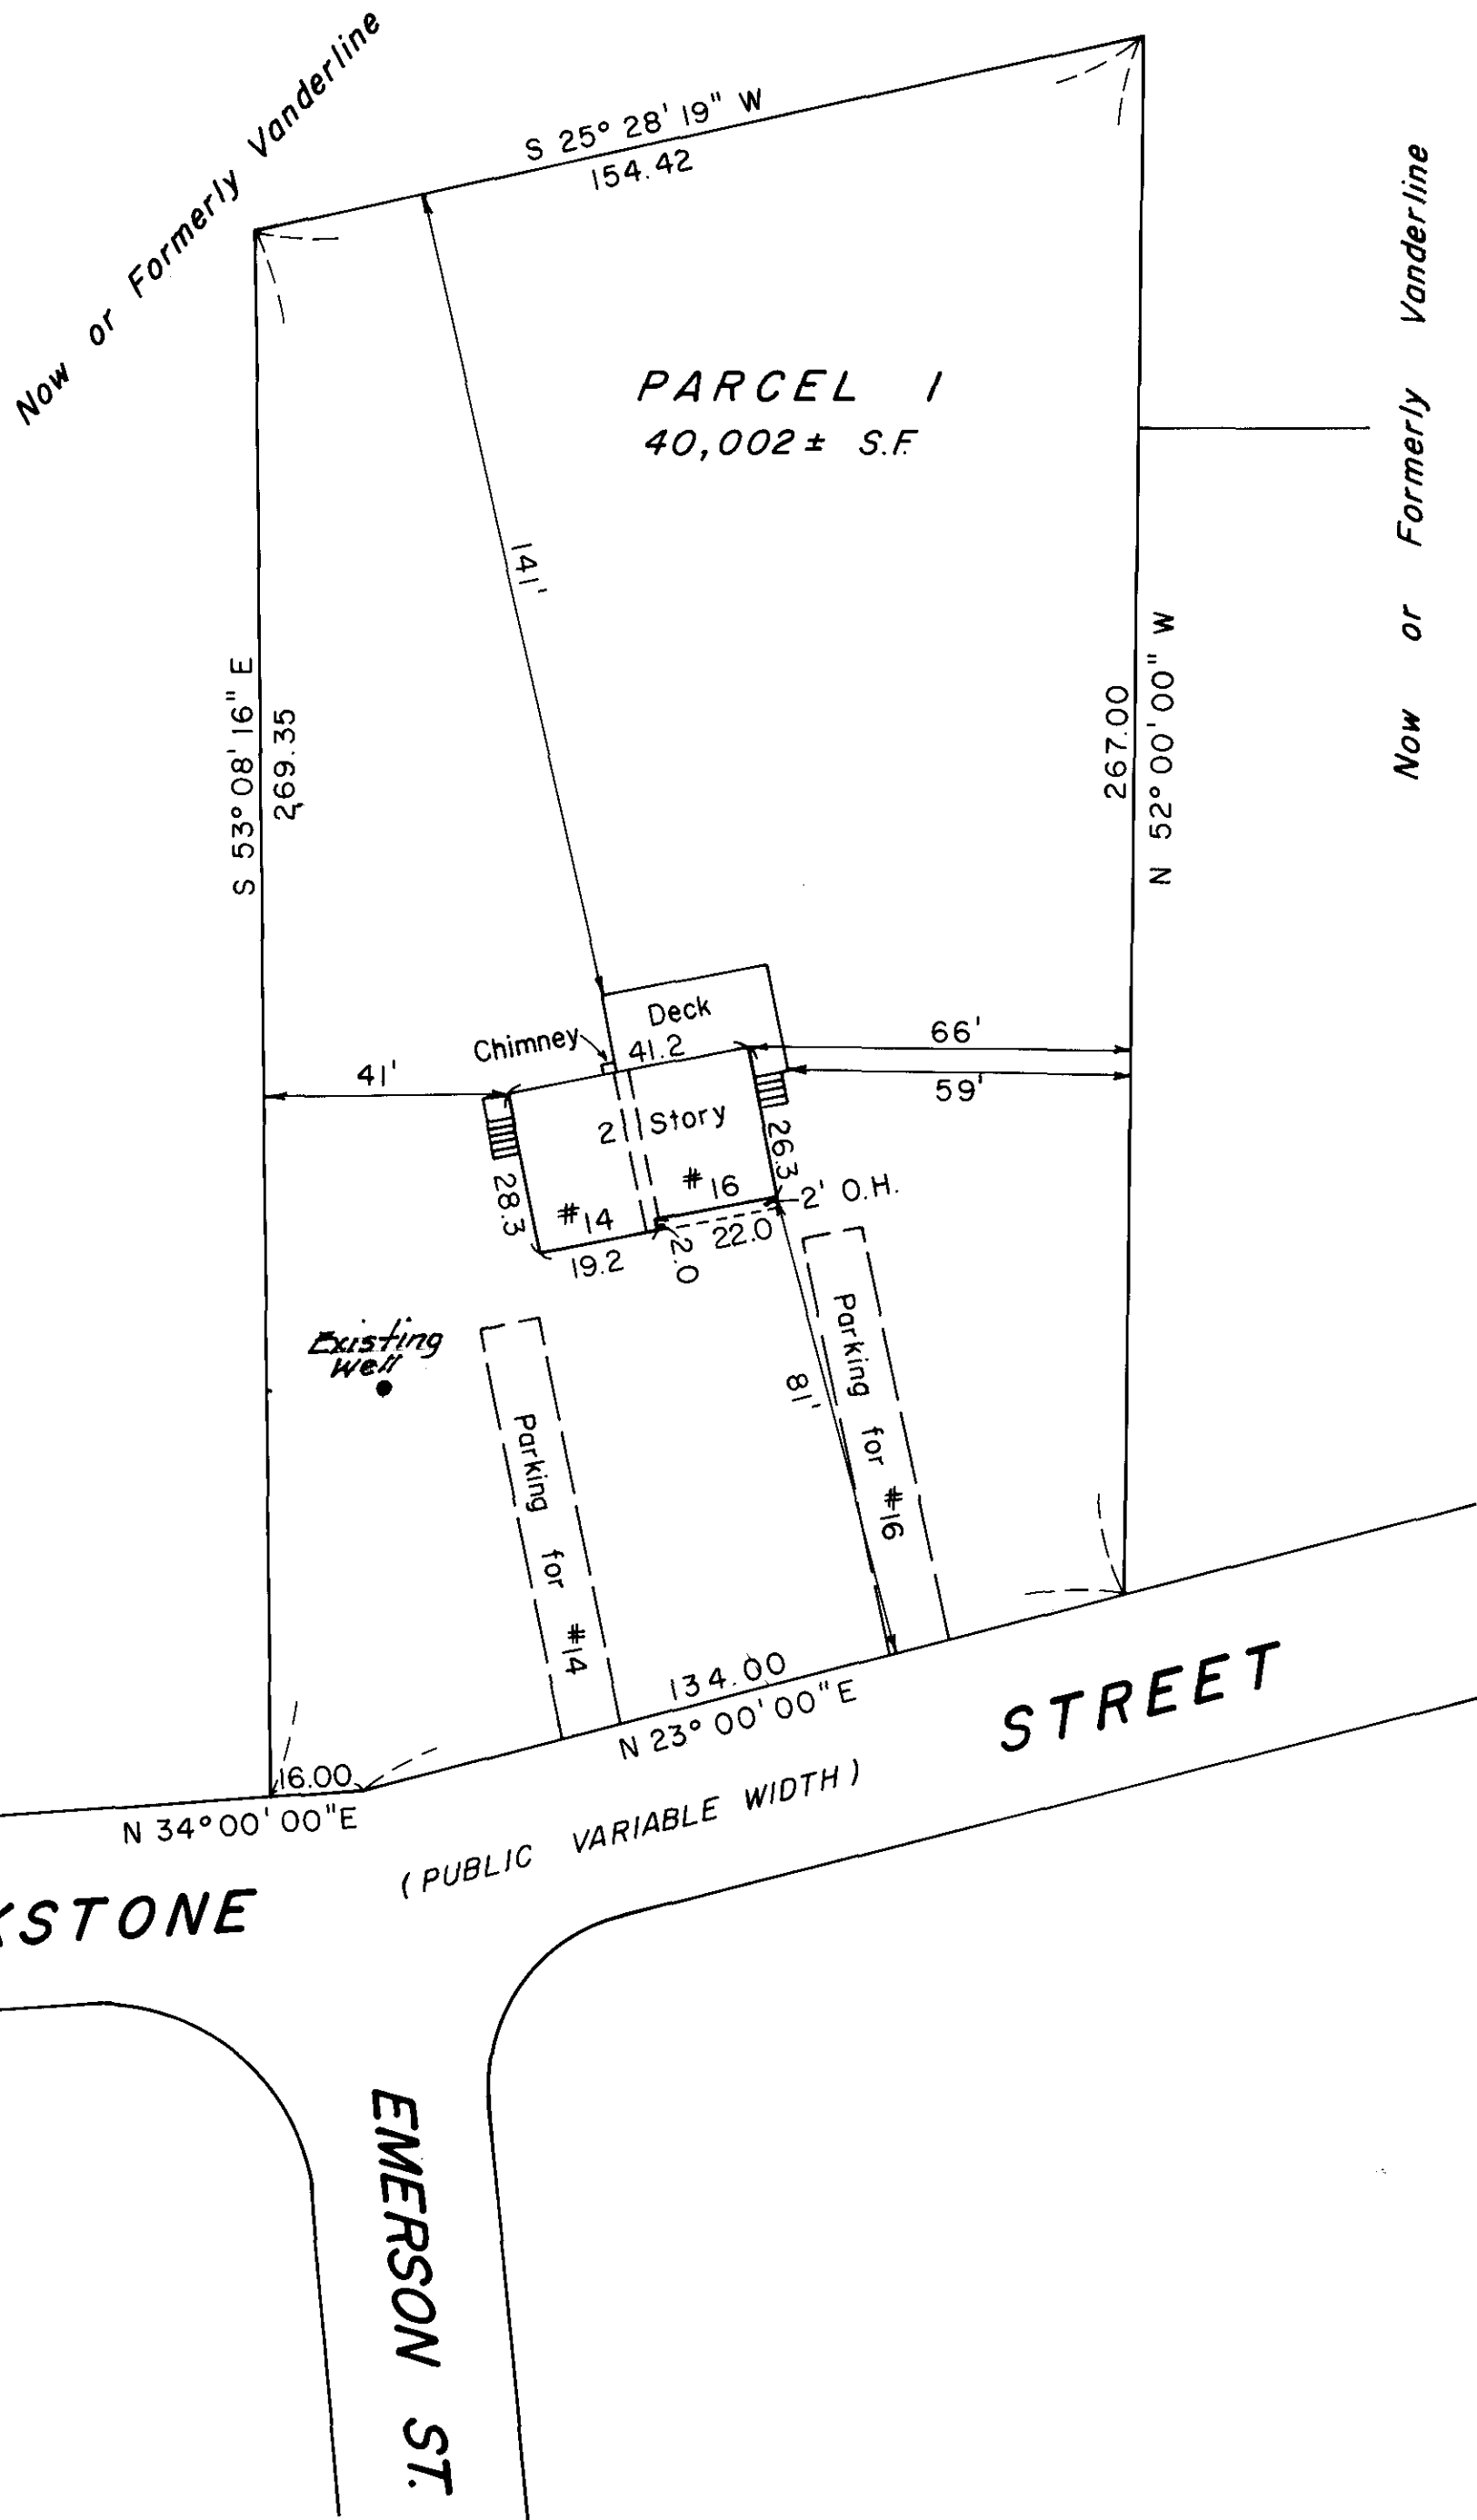

I HEREBY CERTIFY THAT THE PROPERTY LINES SHOWN
ON THIS PLAN ARE THE LINES DIVIDING EXISTING
OWNERSHIPS, AND THE LINES OF THE STREETS AND
WAYS SHOWN ARE THOSE OF PUBLIC OR PRIVATE
STREETS OR WAYS ALREADY ESTABLISHED, AND THAT
NO NEW LINES FOR DIVISION OF EXISTING OWNERSHIP
OR FOR NEW WAYS ARE SHOWN.

THE CERTIFICATION SHOWN HEREON IS INTENDED TO
MEET REGISTRY OF DEEDS REQUIREMENTS AND IS NOT
A CERTIFICATION TO THE TITLE OR OWNERSHIP OF THE
PROPERTY SHOWN. OWNERS OF ADJOINING PROPERTIES
ARE SHOWN ACCORDING TO CURRENT TOWN OF
MENDON ASSESSORS RECORDS.

Paul J. Desimone
DATE: 11/7/87

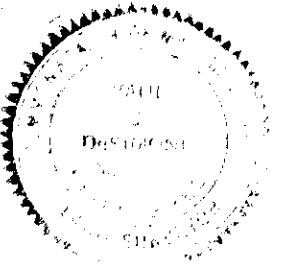

I CERTIFY THE BUILDINGS HEREON MEET THE SETBACK
AND OFFSET REQUIREMENTS OF THE MENDON ZONING
BY LAWS.

Paul J. Desimone
DATE: 11/7/87

NOTES:
1. THE BUILDING HAS NO NAME.

"AS BUILT" SITE PLAN
OF
#14-#16 BLACKSTONE ST.
CONDOMINIUM
IN
MENDON, MASS.

OWNER: BRIAN & ELLEN SANSOUCI, & BEVERLY COSTELLO
SCALE: 1" = 30' DATE: OCTOBER 30, 1987

DESIMONE SURVEYING SERVICES, INC.
38 COFFEE ST. MEDWAY, MASS.

NOTE:
REFER TO A PLAN BY GUERRIERE AND HALNON, INC.
DATED JUNE 28, 1985.

