

111174

UNIT DEED

Joa

I, James E. Hastie, Jr. of Mendon, Worcester County, Massachusetts for consideration paid of One \$1.00) Dollar, grants to James E. Hastie, Jr. (the "Grantee") of Unit B, 81 Hartford Avenue East Condominium, Mendon, Worcester County, Massachusetts.

With QUITCLAIM COVENANTS, Unit B (the "Unit") a Unit in the Condominium located at Hartford Avenue East, Mendon, Massachusetts, known as 79-81 Hartford Avenue East Condominium, (the "Condominium"), created pursuant and subject to the provisions of Chapter 183A of the General Laws of Massachusetts, by Master Deed dated 8-31-00 and recorded on 9-15-00 as Instrument No. 111167.

Property Post Office address is 81 Hartford Avenue East, Mendon, Worcester County, Massachusetts, 01756.

The Unit is conveyed together with an undivided 50.00 percentage interest appertaining to said Unit in the common areas and facilities of the Condominium, together with the rights and easements appurtenant to the Unit as set forth in the said Master Deed.

The Unit contains approximately 1,536.7 square feet, and is laid out as shown on a plan attached hereto to which is affixed the verified statement of a registered land surveyor certifying that the plan shows the unit designation of the Unit hereby conveyed and of the immediately adjoining unit, and that it fully and accurately depicts the layout of the Unit, its location, dimensions, approximate area, main entrance, and immediate common area to which it has access, as built.

The Unit may be used for residential purposes permitted by the Zoning By-Laws of the Town of Mendon.

The Unit hereby conveyed is intended to be used for residential purposes, and is subject to the restrictions, as set forth in Section 9 of said Master Deed, and Section 5.6 of the 79-81 Hartford Avenue East Condominium Trust dated 8-31-00, recorded on 9-15-00 as Instrument No. 111167 unless otherwise permitted in writing by the Trustee of said 79-81 Hartford Avenue East Condominium Trust.

These restrictions shall be for the benefit of all Unit Owners and shall be administered on behalf of the Unit Owners by the Trustee of the Condominium Trust and shall be enforceable solely by one or more Unit Owners or Trustees, insofar as permitted by law, and, insofar as permitted by law shall be perpetual; and to that end may be extended at such time or times and in such manner as permitted or required by law for the continued enforceability thereof. No Unit Owner shall be liable for any breach of the provisions of this paragraph except such as occur during his or her Unit ownership.

The Unit and the undivided interest in said common areas and facilities hereby conveyed are conveyed (i) subject to the provisions of said Chapter 183A and to taxes attributable

MAIL TO:
HOLLAND, SULLIVAN & MCLAUGHLIN, PC
Attorneys at Law
P.O. Box 268
12 Congress Street
Milford, MA 01757


81 HARTFORD AVENUE EAST
MENDON, MA

00 SEP 15 PM 1:23

thereto for the current fiscal year as are not now due and payable; (ii) subject to and with the benefit of the provisions and all the rights, restrictions, easements, agreements and other matters referred to or set forth in said Master Deed (including, without limitation, in Exhibit "A" thereof), and the Declaration of Trust for the said 79-81 Hartford Avenue East Condominium Trust dated 8-3-00, and recorded with the Worcester District Registry of Deeds on 7-25-00, as Instrument No. 111168 and the By-Laws contained therein and the obligations thereunder to pay the proportionate share attributable to said Unit of the expenses of the Condominium set forth in said Declaration of Trust; all as amended from time to time in accordance with their terms; (iii) subject to all easements, restrictions, agreements and other matters of record affecting said Unit and said common areas and facilities insofar as now in force and applicable; all of which the grantee (jointly and severally, if more than one grantee) by acceptance and recording hereof agrees to comply with, perform, assume and pay; and (iv) subject to real estate taxes attributable to said Unit which are not yet due and payable. SER PLAN 759-122

For title see deed dated 6-1-2000 and recorded in Book 22650 Page 357.

WITNESS the execution hereof, under seal, this 31st day of August, 2000.

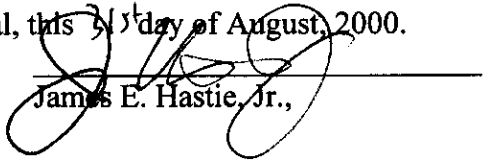
James E. Hastie, Jr.,

COMMONWEALTH OF MASSACHUSETTS

Worcester, ss.

August 31, 2000

Personally appeared the above-named JAMES E. HASTIE, JR., and acknowledged the foregoing instrument to be his free act and deed, before me


Raymond M. Mastroianni
Notary Public

My Commission Expires: May 17, 2007

NOTES:

1. ELEVATIONS SHOWN REFER TO USGS DATUM OF 1929
2. EXTERIOR OFFSETS ARE MEASURED FROM FOUNDATIONS PERPENDICULAR TO PROPERTY LINES
3. REFERENCE IS MADE TO PLAN BK. 302 PLAN 46

"I CERTIFY THAT THIS PLAN SHOWS UNIT "B" BEING CONVEYED AND THAT IT FULLY AND ACCURATELY DEPICTS THE LAYOUTS, LOCATIONS, DIMENSIONS, APPROXIMATE AREAS, MAIN ENTRANCES AND IMMEDIATE COMMON AREAS TO WHICH THEY HAVE ACCESS, AS BUILT"

I HEREBY CERTIFY TO THE BEST OF MY PROFESSIONAL KNOWLEDGE, INFORMATION AND BELIEF, THAT THE PROPERTY LINES SHOWN ON THIS PLAN ARE THE LINES DIVIDING EXISTING OWNERSHIPS, AND THE LINES OF THE STREETS AND WAYS SHOWN ARE THOSE OF PUBLIC OR PRIVATE STREETS OR WAYS ALREADY ESTABLISHED, AND THAT NO NEW LINES FOR DIVISION OF EXISTING OWNERSHIP OR FOR NEW WAYS ARE SHOWN.

THIS PLAN HAS BEEN PREPARED IN CONFORMITY WITH THE RULES AND REGULATIONS OF THE REGISTRY OF DEEDS IN THE COMMONWEALTH OF MASSACHUSETTS AND IN COMPLIANCE WITH THE RULES AND REGULATIONS FOR THE PRACTICE OF LAND SURVEYING IN THE COMMONWEALTH OF MASSACHUSETTS. THIS CERTIFICATION IS INTENDED TO MEET THE REQUIREMENTS OF THE REGISTRAR OF DEEDS AND IS NOT A CERTIFICATION OF THE TITLE OR OWNERSHIP OF THE LAND SHOWN HEREON.



DATE:

HOLLAND E. SHAW, PLS NO. 30314

PLANNERS • SURVEYORS • ENGINEERS
10 RIVER ROAD, SUITE 121
UNIONVILLE, MASSACHUSETTS 01869
TEL 508-276-7777 FAX 508-276-8484
ALPINE LIABILITY COMPANY

1. UPPER LIMITS OF THE UNITS EXTEND TO BOTTOM OF ROOF BATTERS AND RIDGE POLES
2. ALL INTERIOR DIMENSIONS ARE TO FACE OF STUDS.
3. BUILDING OFFSETS TO PROPERTY LINES TAKEN TO FOUNDATION (OFFSETS AT 90° TO THE LOT LINES).
4. ALL ELEVATIONS REFER TO U.S.G.S. DATUM OF 1929.



I CERTIFY THAT THE PLAN SHOWS UNITS "A" & "B" BEING CONNECTED AND THAT IT FULLY AND ACCURATELY REPRESENTS THE LAYOUT, LOCATIONS, DIMENSIONS, APPROPRIATE AREAS, MARK ENTRANCES AND IMMEDIATE COMMON AREAS TO WHICH THEY HAVE ACCESS, AS SHOWN



HENRY CERTIFY TO THE BEST OF MY PROFESSIONAL
KNOWLEDGE, INFORMATION AND BELIEF, THAT THE
PROPERTY LINES SHOWN ON THIS PLAN ARE THE LINES
AMONGST EXISTING OWNERSHIP, AND THE LINES OF
THE STREETS AND WAYS SHOWN ARE THOSE OF
PUBLIC OR PRIVATE STREETS OR WAYS ALREADY
ESTABLISHED, AND THAT NO NEW LINES FOR DRAINAGE
EXISTING OWNERSHIP OR FOR NEW WAYS ARE
SHOWN.

THIS PLAN HAS BEEN PREPARED IN CONFORMITY WITH THE RULES AND REGULATIONS OF THE RESIDENT OF THE DISTRICT IN CHARGE OF THE LANDS AND MINES AND IN ACCORDANCE WITH THE RULES AND REGULATIONS FOR THE CONVEYANCE OF LAND SURVEYS IN THE PROVINCE OF SASKATCHEWAN. THIS CERTIFICATION IS INTENDED TO MEET THE REQUIREMENTS OF THE REGISTRATION OF DEEDS AND IS NOT A CERTIFICATION OF THE TITLE OR OWNERSHIP OF THE LAND SHOWN HEREON.

DATE: HOLLAND E. SHAW, FLS NO. 30314

CONDOMINIUM FLOOR PLAN
 81 HARTFORD AVENUE EAST CONDOMINIUM
 MENDON, MASSACHUSETTS
 PREPARED FOR
 JAMES E. HASTIE, JR.
 280 VILLAGE STREET, C-2
 MEDWAY, MASSACHUSETTS
 SCALE: 1" = 4' JULY 5, 2000

~~REF 2 OF 2~~

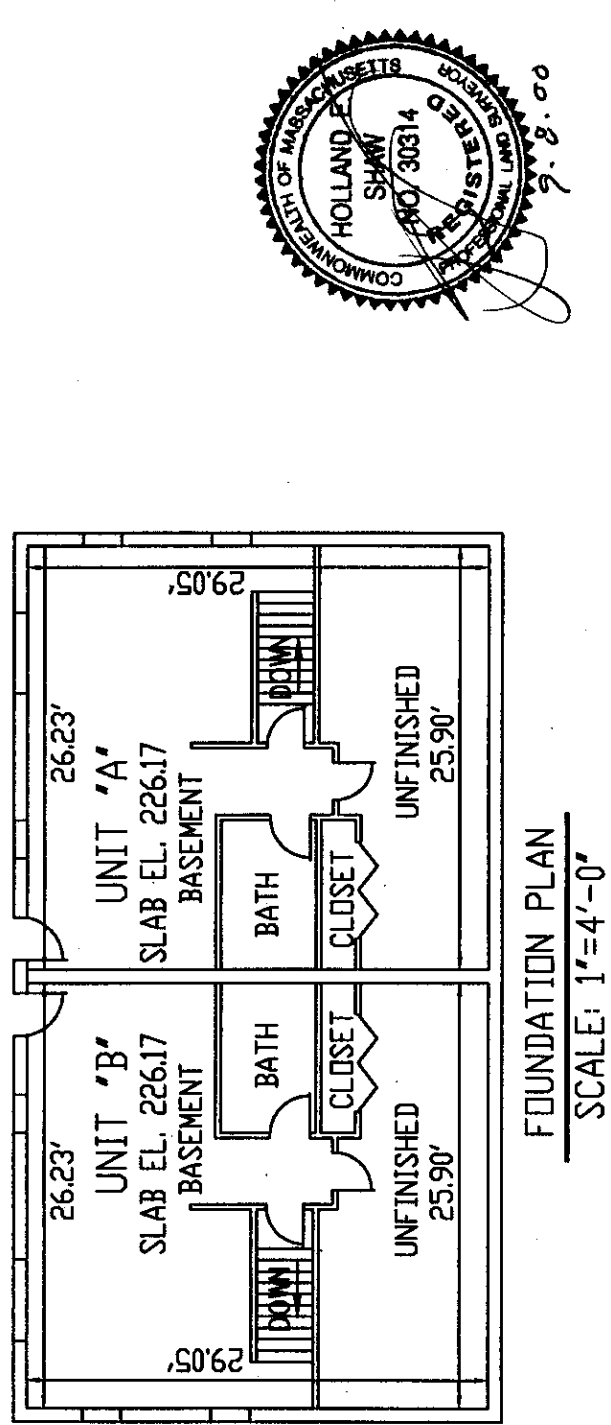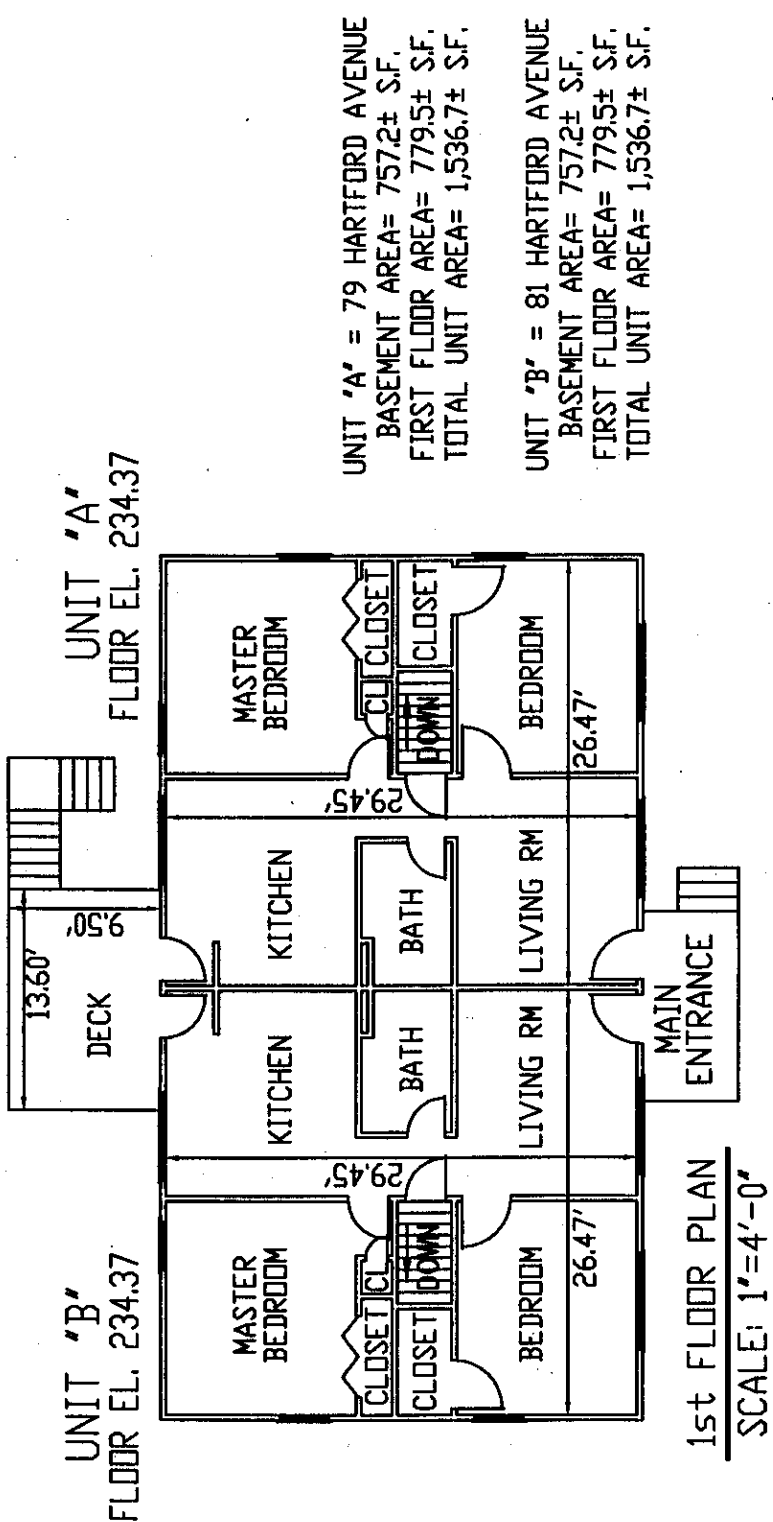

ATTEST: WORC. Anthony J. Vigliotti, Register